


Sec. 27 T. 1N R. 33E

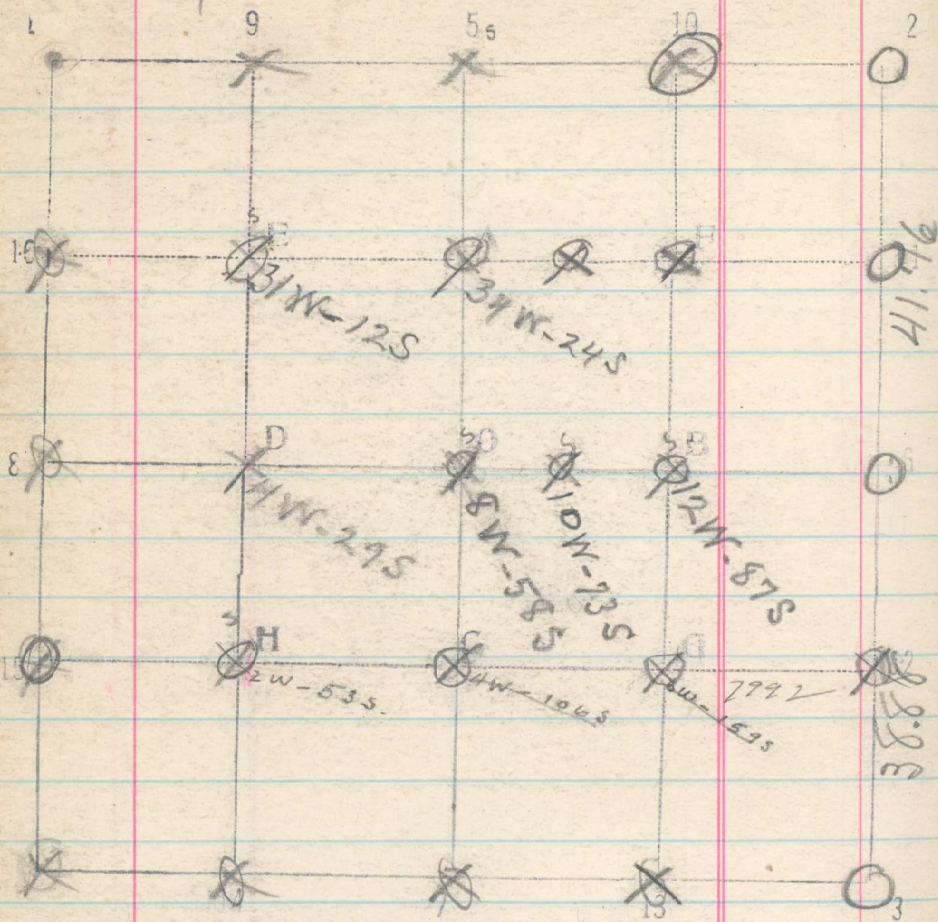

525