42

Sec. 10 T. 1 N R. 3 & E

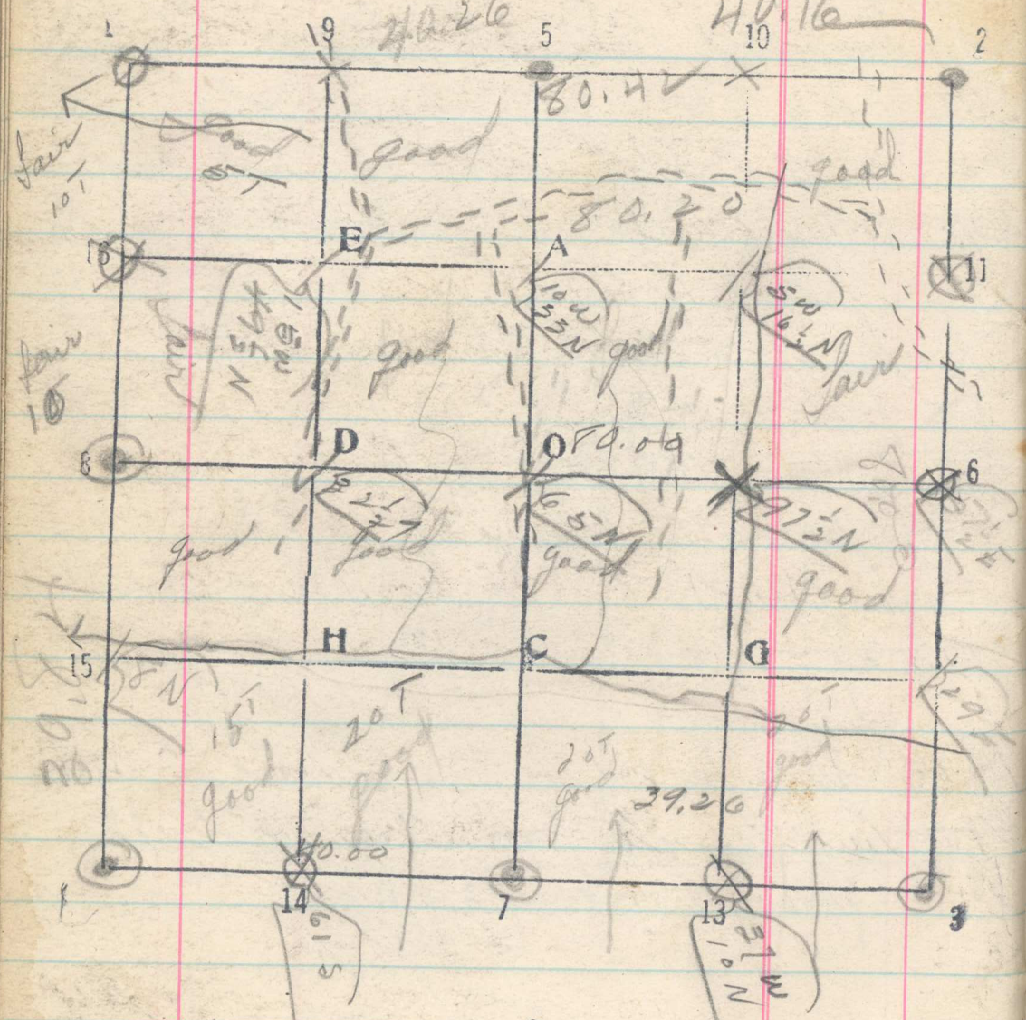

360

10/10 Line 8-4 South from 1/4 Cor between 10 & 11
Set 20
18 Raine Shed West
39.84 Sec. Cor 9-10-15-16 on line.
10/11 Line 7-7 East between 10 & 15
Set 20 / 21 Raine Shed N
40 1/4 Cor bears S 122 lks
10/11-12 Line 7-3 East from 1/4 Cor between 10 & 15
Set 20 / 13 Raine Shed N / 7 Raine N
39.26 Sec. Cor 10-11-14-15 bears N 20 lks
10/12 Line 3-2 North between 10 & 11
Set 20-40-60
80.00 Sec Cor. 2-3-10-11 bears E 11 3/4 lks
10/14 Line 5-6 East from Auto
Set 20-40-60
80.00 1/4 Cor bears N 130 lks
10/13-14 Line 11-16 West thru north half
Set 20-40-60
80.20 1/16 Cor. 16 bears N 6 lks