


4

T. 2N R. 34E
 See next page 10 2

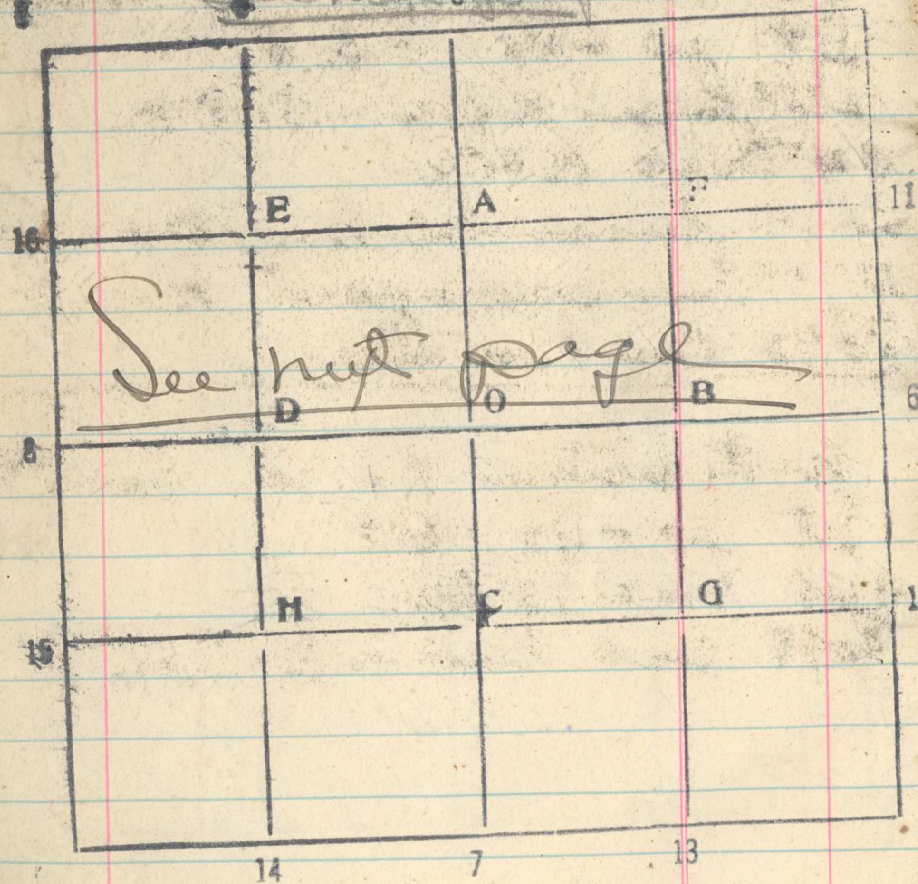

Copy from book (2)

480

North between 10 + 11 line 4-1
 Set 20-40-60
 275° fence N45W - 545 S.
 34° creek N45W
 35, 40 fence + set line N45W - 845 S.
 47° fence corner of road N-W.
 80/12 Cor. 1 on line

West between 11 + 14 line 3-4
 Set 20-40-60
 4925 creek 15 lbs S.
 8098 Cor. 4 beam S. 30 lbs.