


Corners set 8-D-O-B-6

110

Sec. 2 T. 2 R. 34E

1 9 5 10 2

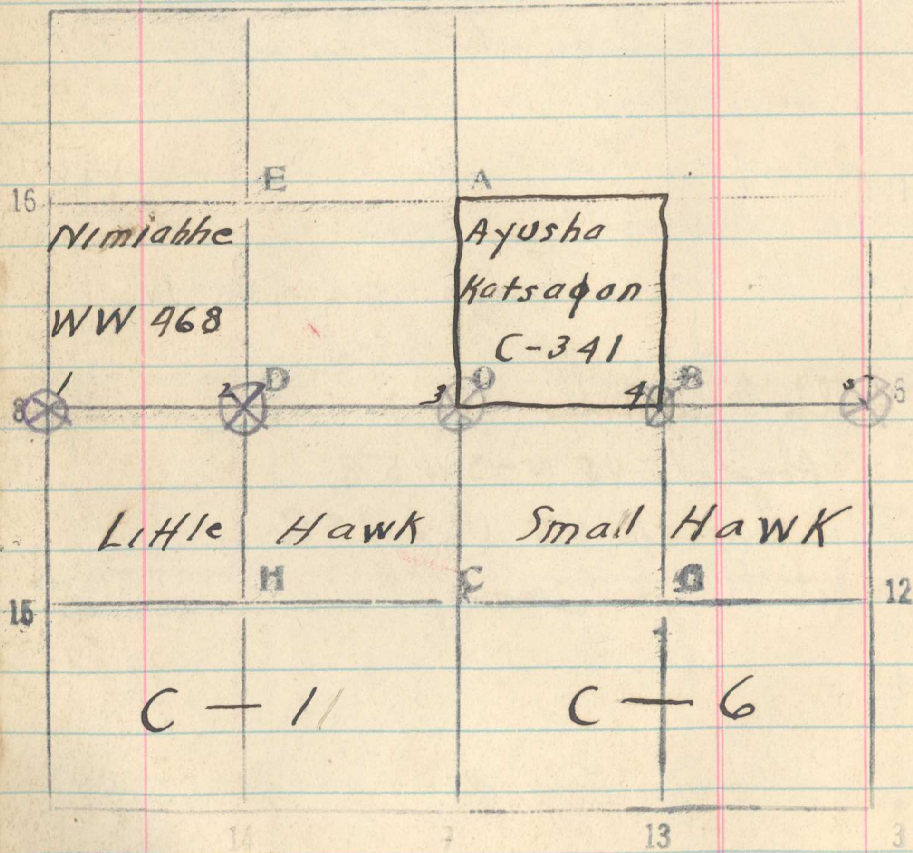

486