


Sec. 11 T. 2N R. 34E.

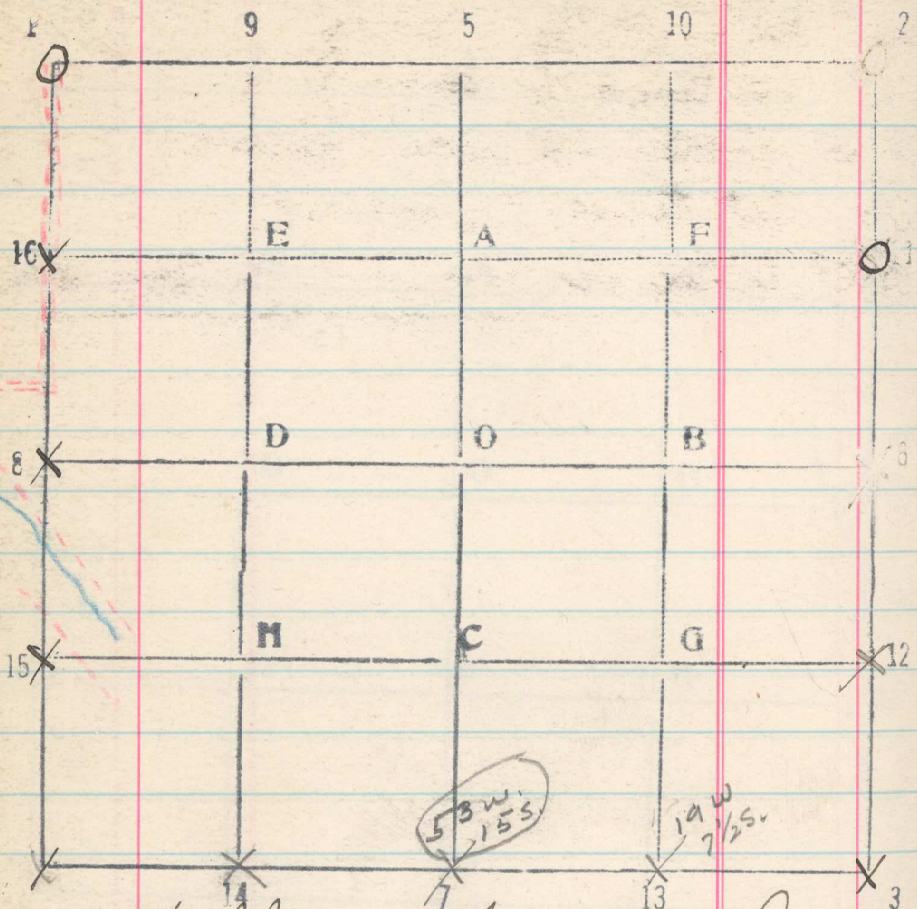

North between Sections 10 & 11 line 4-1

- 20 set temp. cor. 15
- 27.50 fence N. 45W - S. 45E.
- 34. creek N. 45W.
- 35.40 fence and tel. line N. 45W - S. 45E.
- 40. - set temp 1/4 cor. → fence cross road. N + W.
- 47. - set temp cor. 16
- 80.12 Section cor. 10-11-3-2

- West between 11 & 14 line 3-4
20 set temp. 1/16 cor 13

523

40 set temp 1/4 cor 7

40.25 creek 15 hrs. South

60 set temp. 1/16 cor 14.

80.98 Section cor 10-11-14-15 near S. 34E