


Sec. 32 T. 2N R. 35E

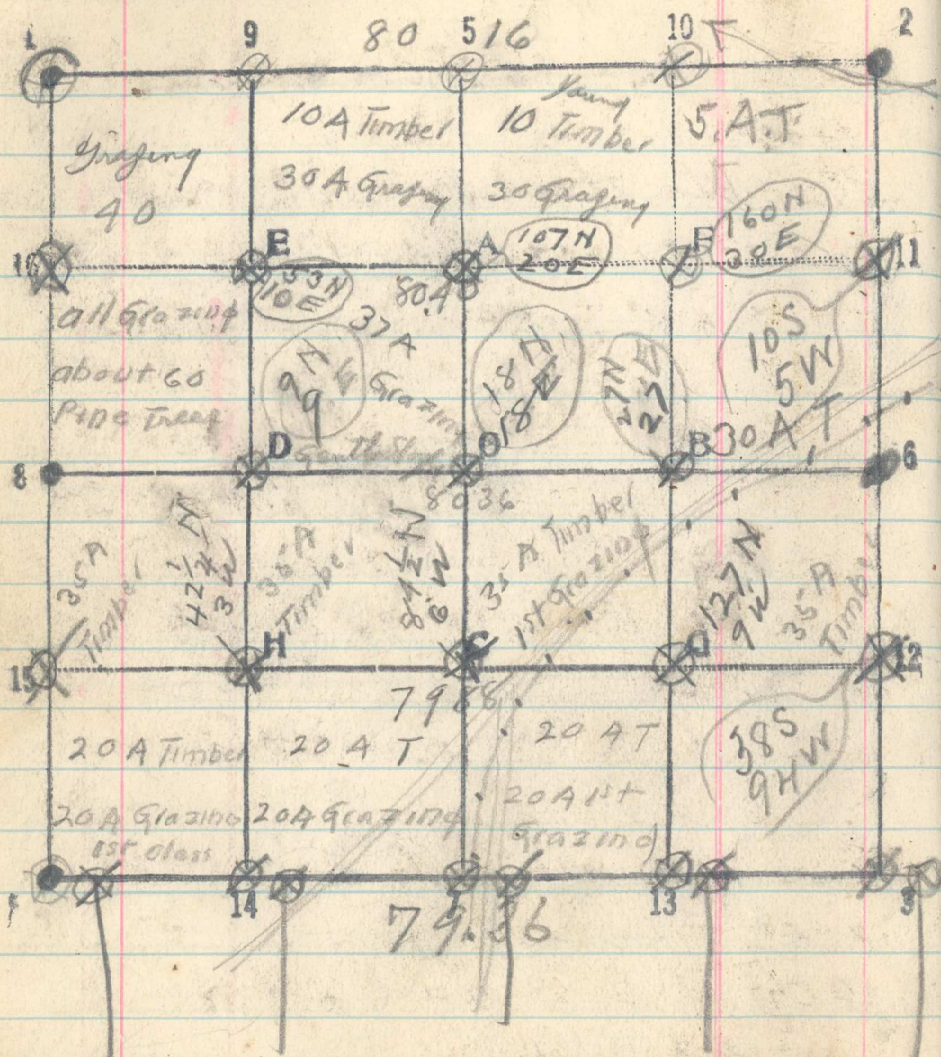

8035
7936
2/13972
7781

8036
7936
8036

8016
8035
2/16052
4020

5966
7716
1242

Monday Oct 27th 1919

435

East Through The South 1/2 sec 32
20-40-60

5728 Chs Hub Triangulate across Revere

$\Delta = 12^\circ 42'$ Base = 400 Chs, A = 4373

5728 + 1774 = 7502

75.02

79.88 Chs cor 11 bears 169 North

Thursday Oct

East Through Center sec 32 @ 30

700 chs bottom ravine side NW

20-40-60

8036 chs 1/4 cor bears 36 N 5 W

East Through N 1/2 sec 32

20-40-60

8040 Chs 11-5-32 bears 214 N

West bet 32 + 29

35.85 Triangulate across ravine 78° 12' 23.93 Chs
59.78 To Pt on west bank

80.16 Chs cor 1 bears 213 South