


Sec. 33 T. 2 R. 35

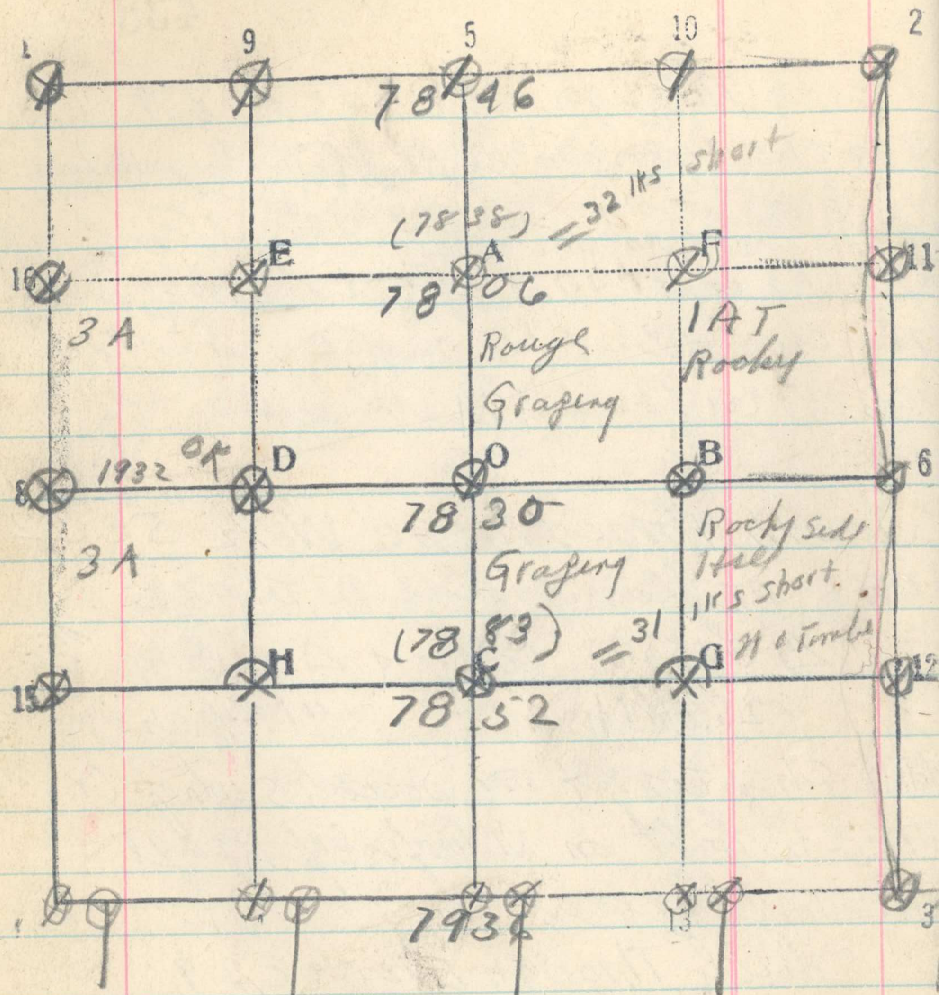

7830	7846
7936	7830
<u>2 15766</u>	<u>2 15676</u>
7783	7898

$\frac{2}{7806}$   
39 03

439