26

Sec. 2 T. 2 N R. 35 E

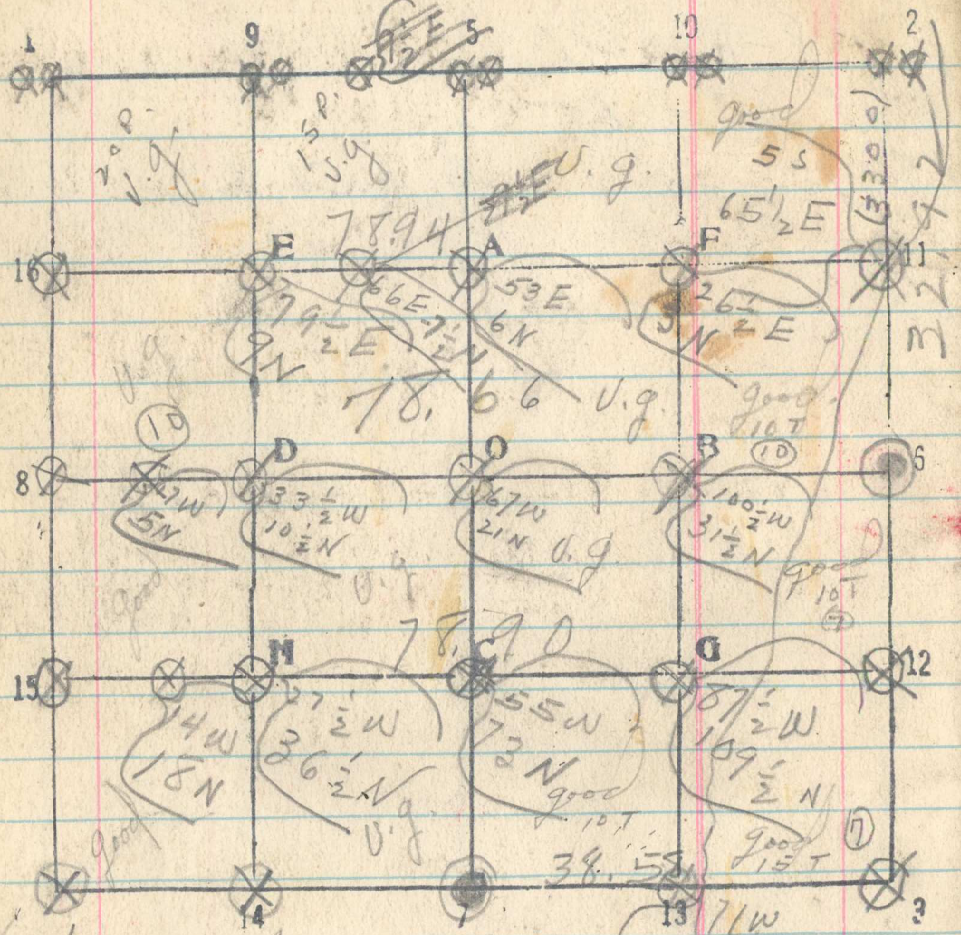

5/15 line 3-1 East from 1/4 cor between 2 & 11

Set 20

20.50 Squaw Creek bears N

38.58 Sec cor 1-2-10-11 on line

5/12 line 8-6 East from center.

Set 10 - 20 - 40 - 60

35 Reached summit. Began steep descent.

72 Squaw Creek Creek North.

78.66 1/4 cor bears N 42 Lks.

5/12 line 6-2 North from 1/4 cor between 1 & 2

Set 20

18. Squaw Crek bears N 20 E.

32.92 C. C. Stations 1 & 2 bears E 108 Lks.

5/12 line 11-16 West from North half.

Set 20 - 30.095 - 40 - 60

55 fence NE - SW.

77 fence N - S.

78.94 1/16 Cor 16 bears N 12 Lks.

5/14 line 15-12

Set 10 - 20 - 40 - 60

78.90 1/16 Cor 12 bears N 146 Lks.