27

Sec. 35 T. 3 N R. 35E

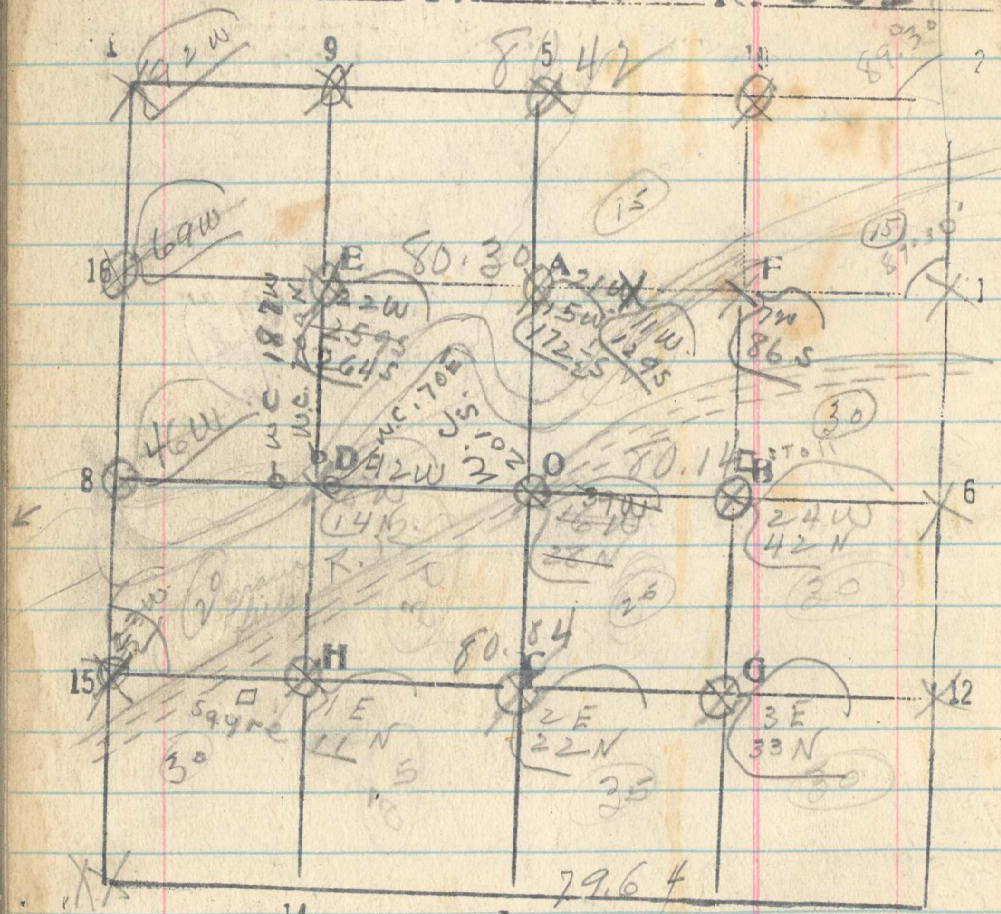

45 Bottom of hill

80.30 ¼ Cor 16 bears S. 34½ Lks.

5/15-19 Line 15-12 East thru South half
Set 20-40-60
7.00 Rail Road. N 60 E - S 60 W.
15 Sagos round 20 ch S. of line.
Set 20 ch pt. set Cor & pits pits.
80.04 ¼ Cor 12 bears N 44 Lks.

5/16-17-19 Line 8-6 East thru Center
Set 20.10-40-60
20 Creek. Unstable. 3 chs wide
course S 60 W.
30 R.R. N 60 E S 60 W
40 Set ¼ Cor. in line.
54.? Road N-S.
~~79.68~~
80.14 ¼ Cor bears N 56 Lks.

5/19 Line 11-16 West thru North half
Set 20-30-40
13 Squaw Creek. Ledge North
27 Umatilla River 4.50 chs Wide
Set stake & 2 s. 20-2 pagos & sd