


31  
 Sec. 14 T. 2 N R. 35 E

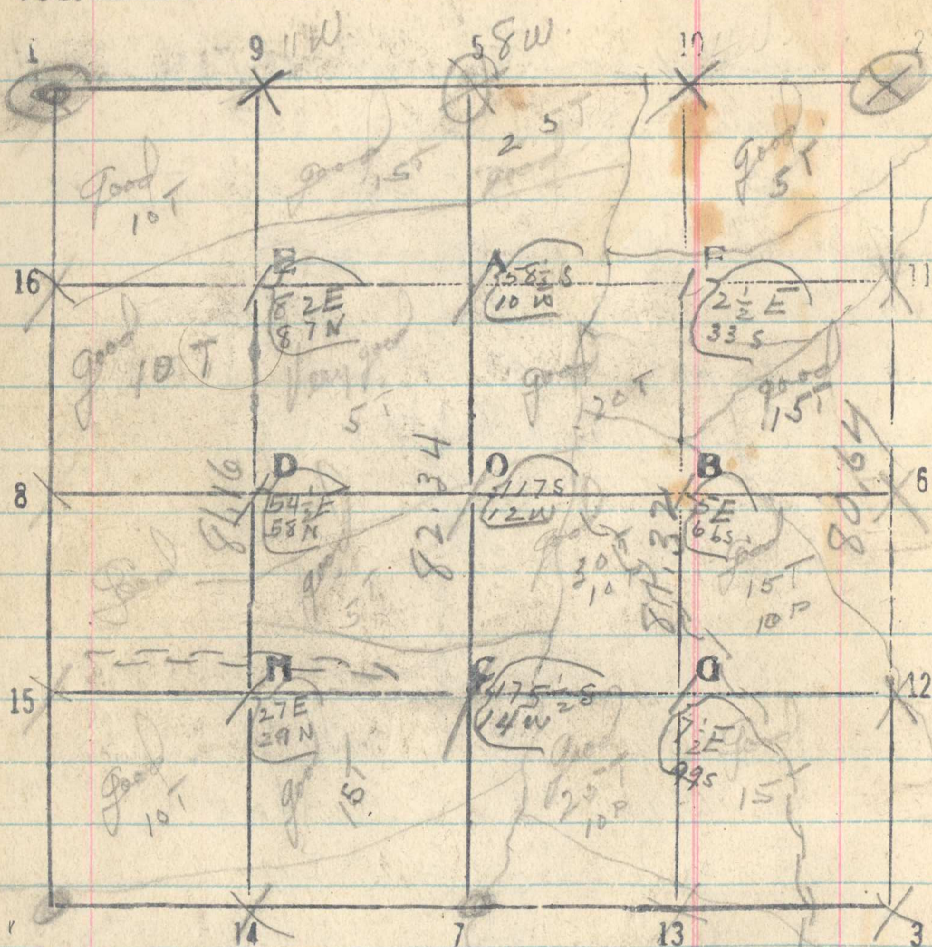

Sec 23 line 9-14. South then West  
 Sit half of Sec 23  
 17 Ravine Sheds E. 50 Square Trunk  
 70 Ravine  
 79.30 1/16 Cor 14 bears W. 140 lks.

507

5/29 line 5-7 South then Center  
 Sit 20-40-60  
 12 Ravine N-70 E. 39.50 Ravine N-60 E.  
 55 Ravine East.  
 82.34 1/4 Cor 9 bears W 150 lks  
 5/6 line 14-9 North then West half  
 Sit 20-40-60  
 5 Ravine Sheds N 80 E.  
 30 Ravine Sheds N 70 E  
 67 Ravine Sheds N 70 E.  
 81.16 Cor bears E 120 lks 169 lks.  
 5/9 line 10-13. South then East half  
 Sit 20-40-60  
 17 Ravine Sheds West  
 35 Ravine Sheds West  
 77 Ravine Sheds North to Center  
 81.32 1/16 Cor. 13 bears E 10 lks.