


37
Sec. 21 T 2N R 35E

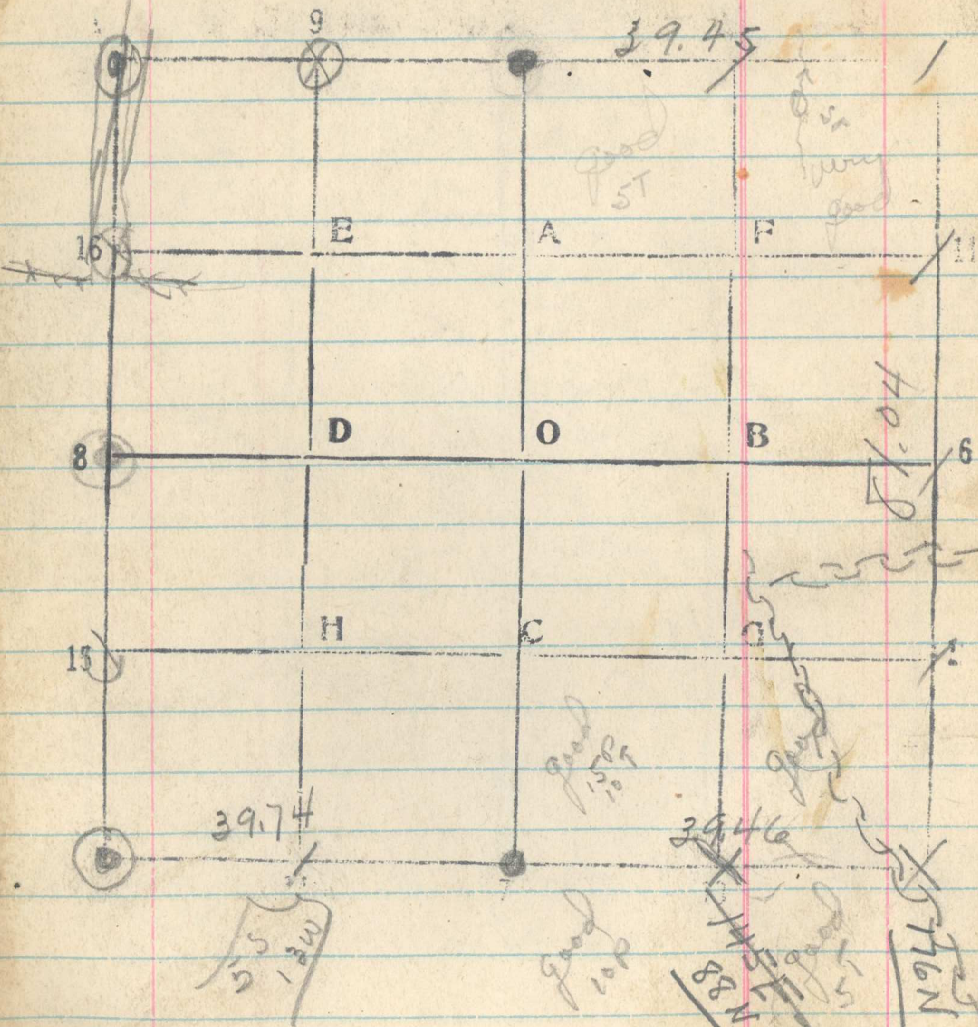

6/16

line 2-5

See Sec. 22

513