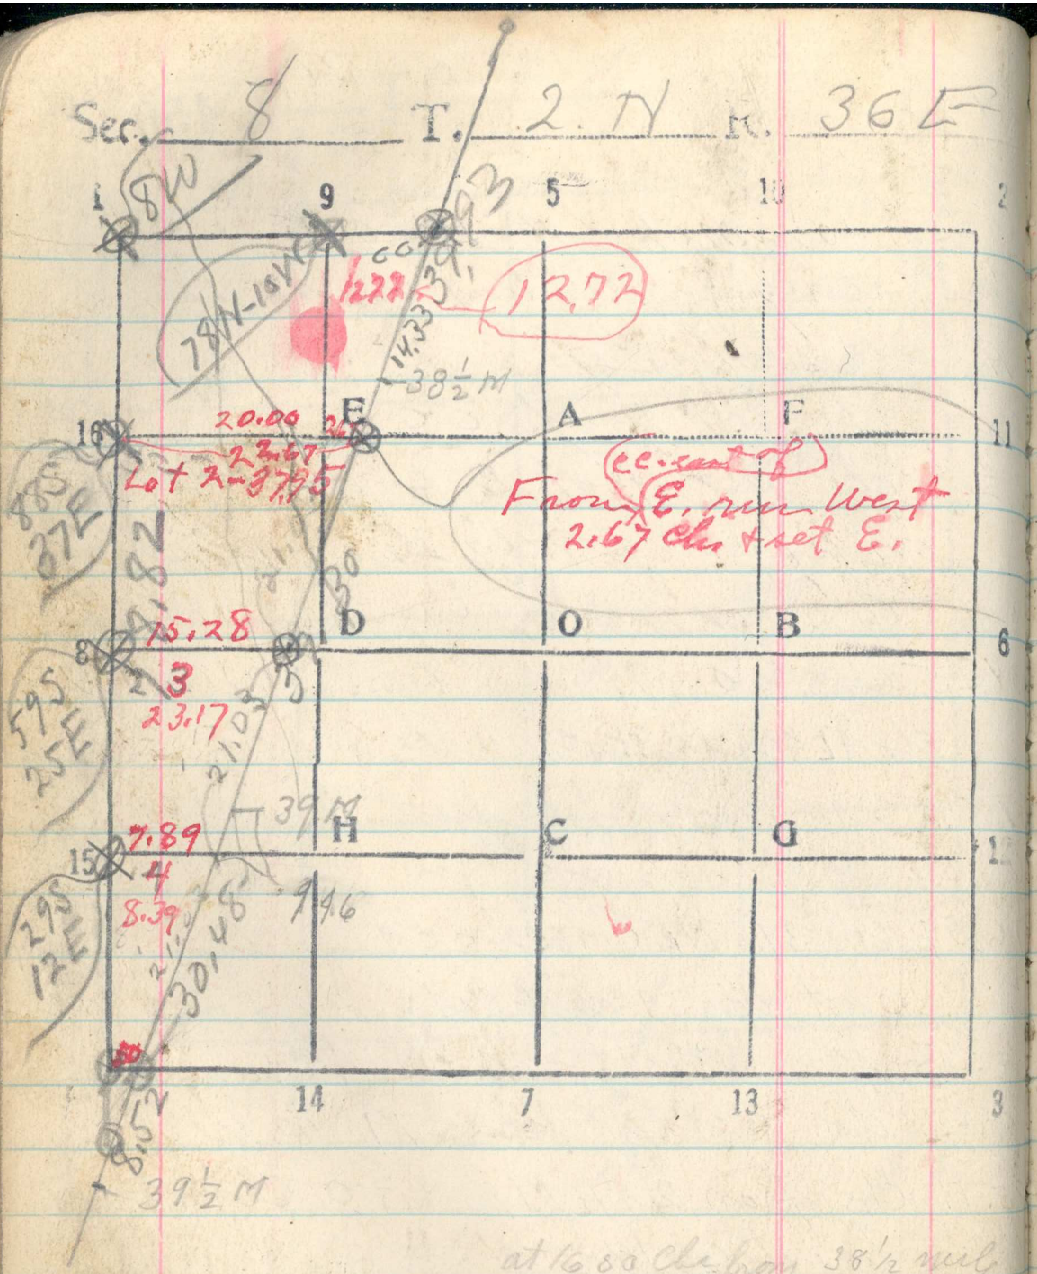

N 26° E from the 39½ mile Corner

14 50 chs long Ridge runs N 48 W + S 60 E + Descend Steep rocky N slope

set

39 00 chs 39 mile Cor bears W like this

Thence from 39 mile Cor Run North on rec. Bdy over steep rough hill descending

18 00 chs creek sheds N 40° W + ascend

35 00 chs ridge E + W

38.25 chs ravine sheds West

39 30 chs 38½ mile Post bears 17 lks West from 38½ M Cor N 20° E

13 53 chs to stake from which Temp. CC bears 34½ links East Marked Temp. CC 30.05

Thence Descend steep brush N slope

29.00 chs ravine sheds West

39 93 chs 38 Mile Cor bears 18 lks West

at 6 00 chs from 38½ mile Cor look for CC

at 13 00 chs Redfield Cor to be set to perp CC