


Sec. 9

T3N

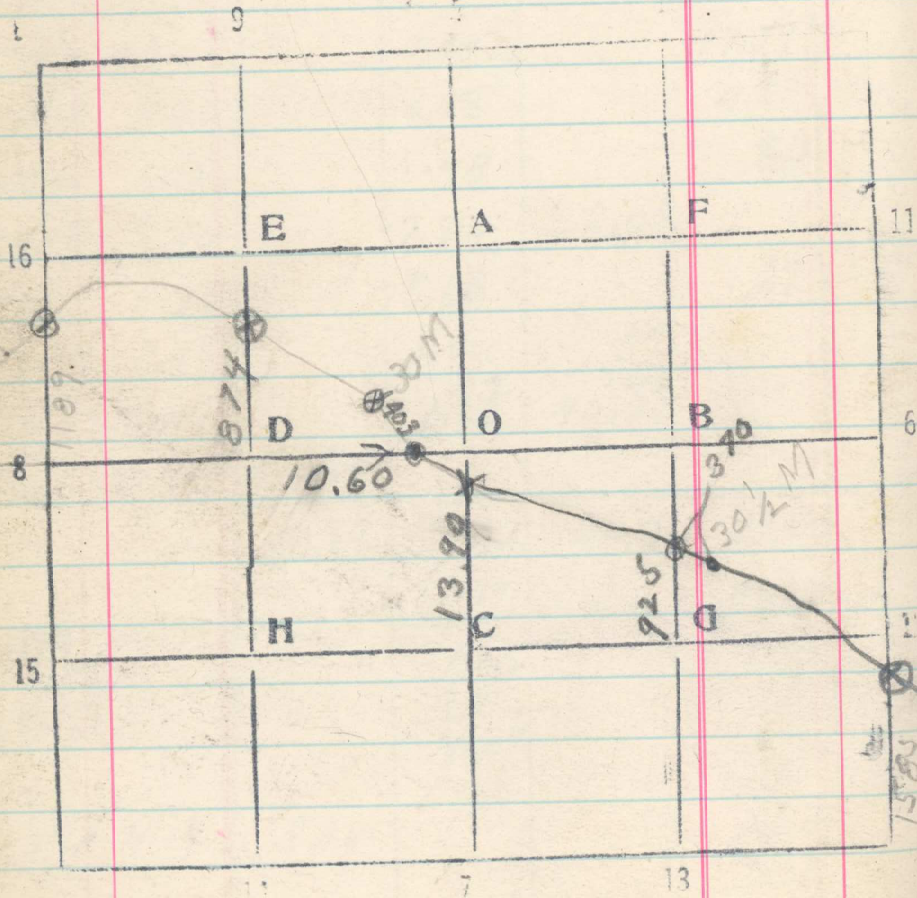

Sec. 8

