



sec 18

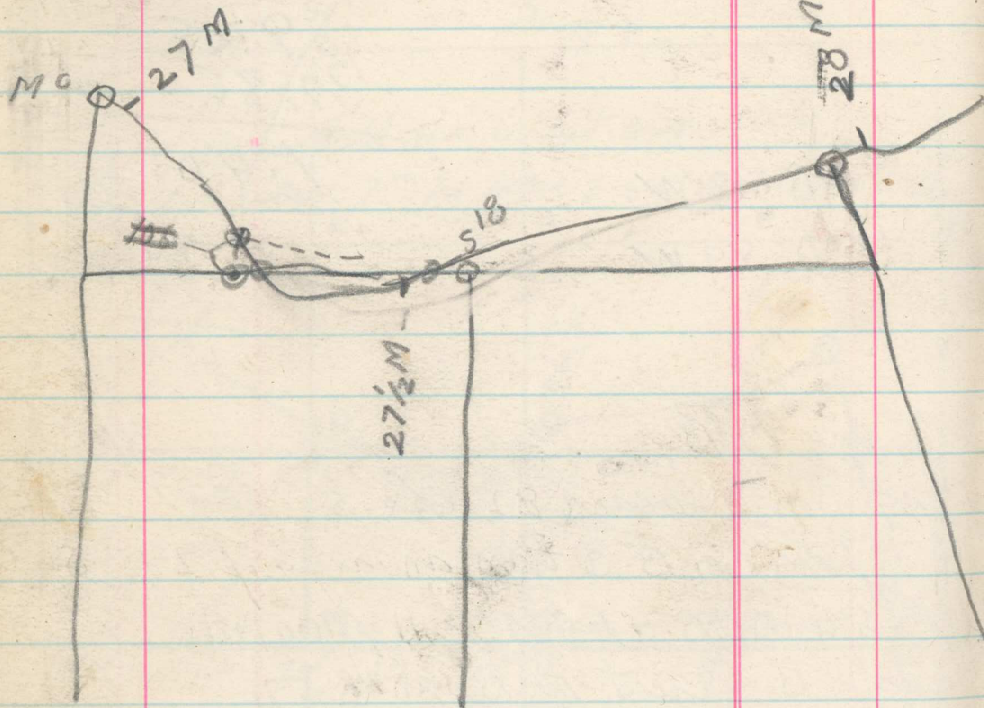

95

400

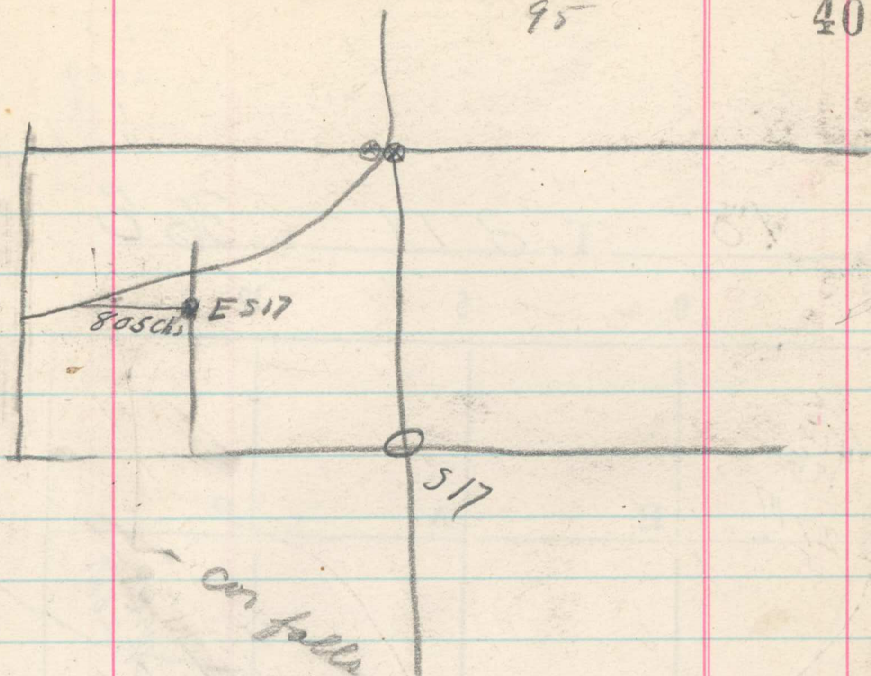

on falls in creek with WC 20 ft N