21

Sec. 23 T. 3 N R. 3 5 E.

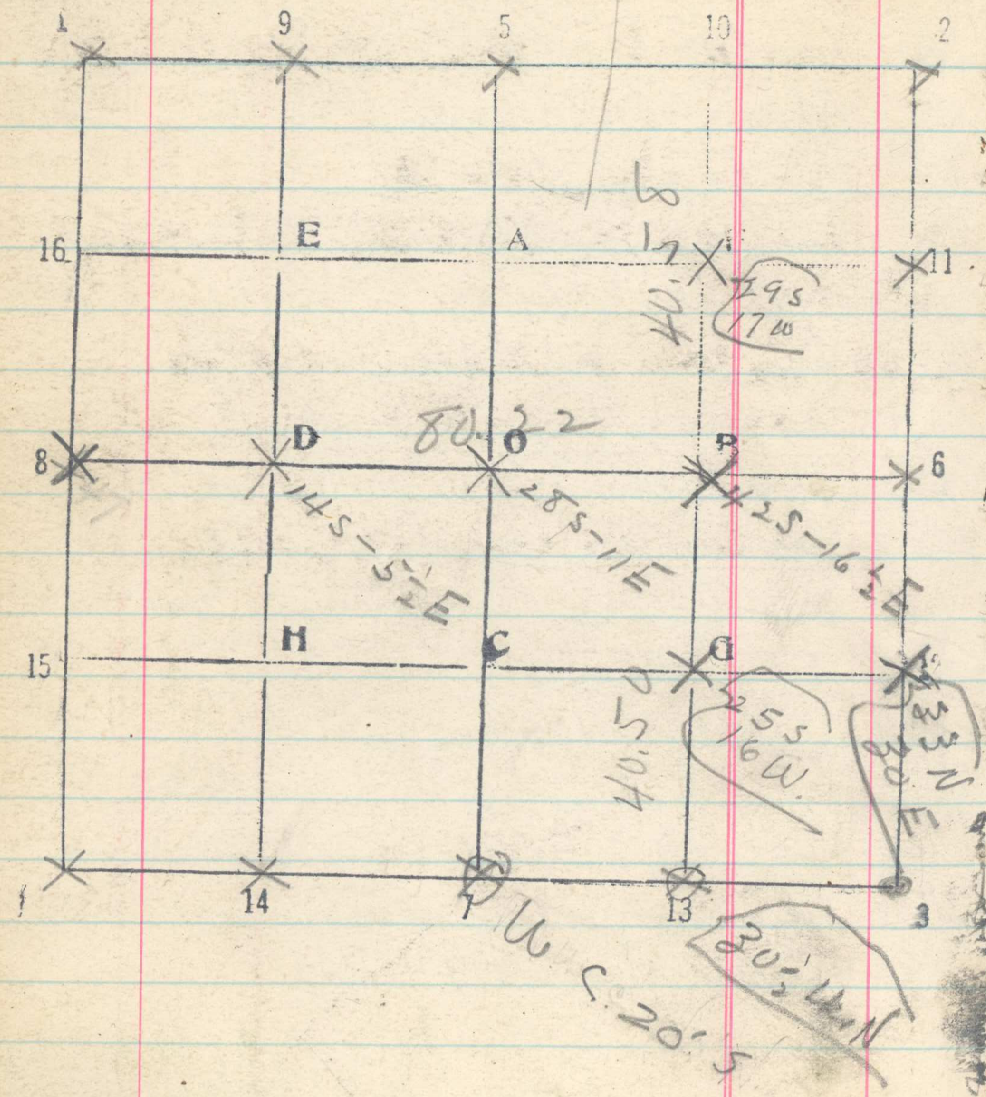

7/11 Line 2-5 West between 14 & 23.

Set 20

40.05 1/4 Cor. bears S 10 lks.

7/11 Line 10-B. South thru East half.

Set 20

40.58 1/16 Cor. B. bears W. 34 lks.

7/11 Line B-13. South thru East half.

Set 20

40.50 1/16 Cor 13 bears W. 32 lks.