


Sec. 9 T. 3N R. 36E

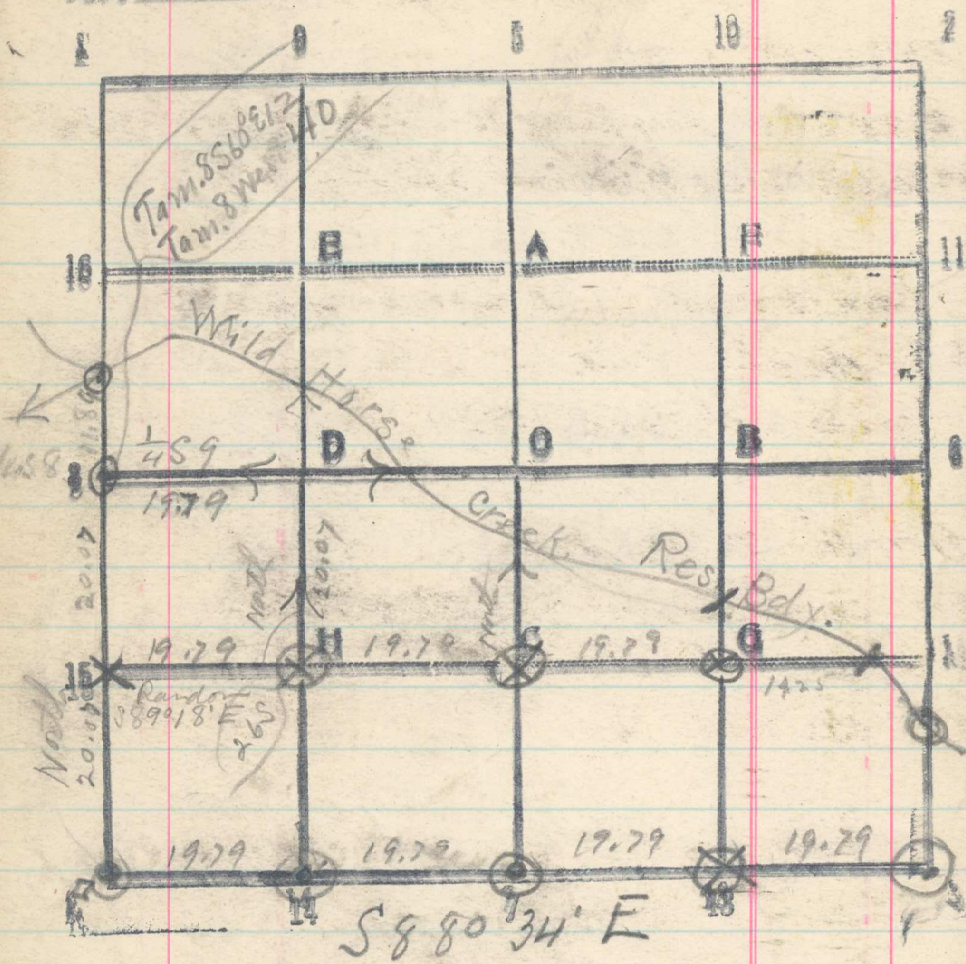

Monday Sept 29<sup>th</sup> 1909

388

Line H-D 16.50 chs wagon road N 60° E

2007 set D-S9

1888° 34' W from Temp D through thick brush  
1980 chs 1/4 cor & bears 1 ch. North

From D North 11.50 chs to Temp 19C  
10.30 chs chs wild Horse cr  
11.50 chs set Temp 19C

From D S 88° 34' E  
4.90 chs wagon Road N 70° E + 5.40 W  
9.20 chs to ch bottom  
14.25 chs Temp 19C

From C North  
15.20 chs set Temp 19C