


Ser. 21 T. 3 N R. 36 E

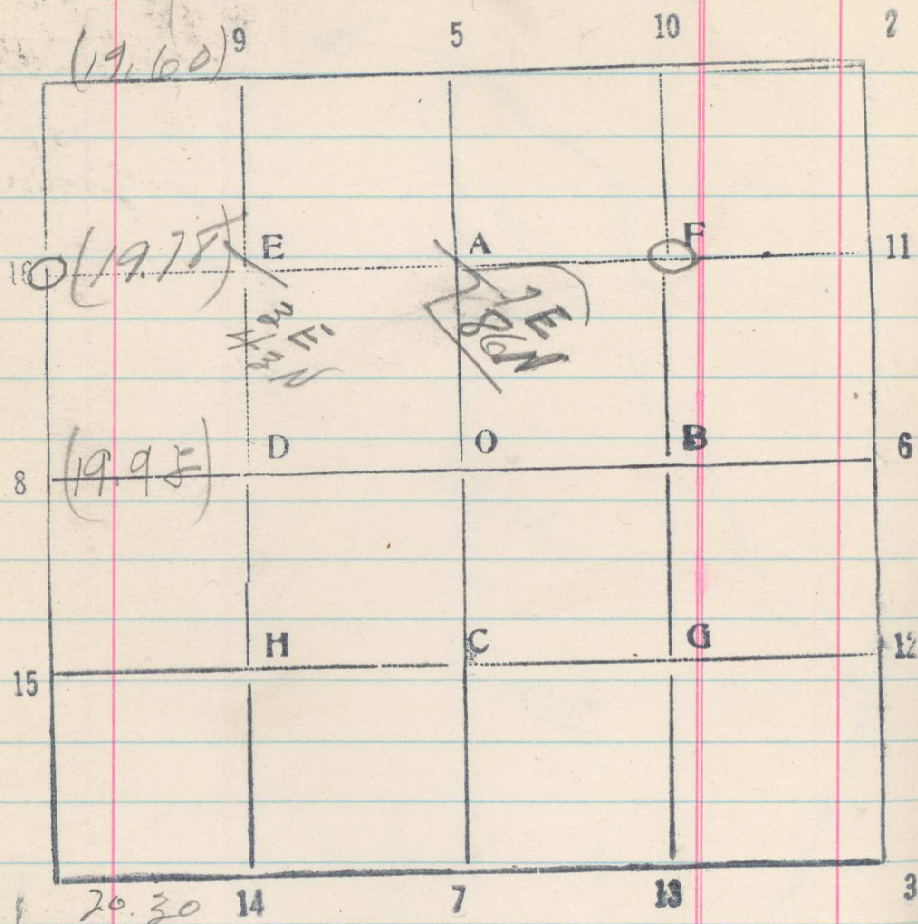

574

1/4 line 16 - S. Range East thru N half
Set 19.78 - 29.78
59.88 (+10) 1/6 Cor & bears N 129 kko