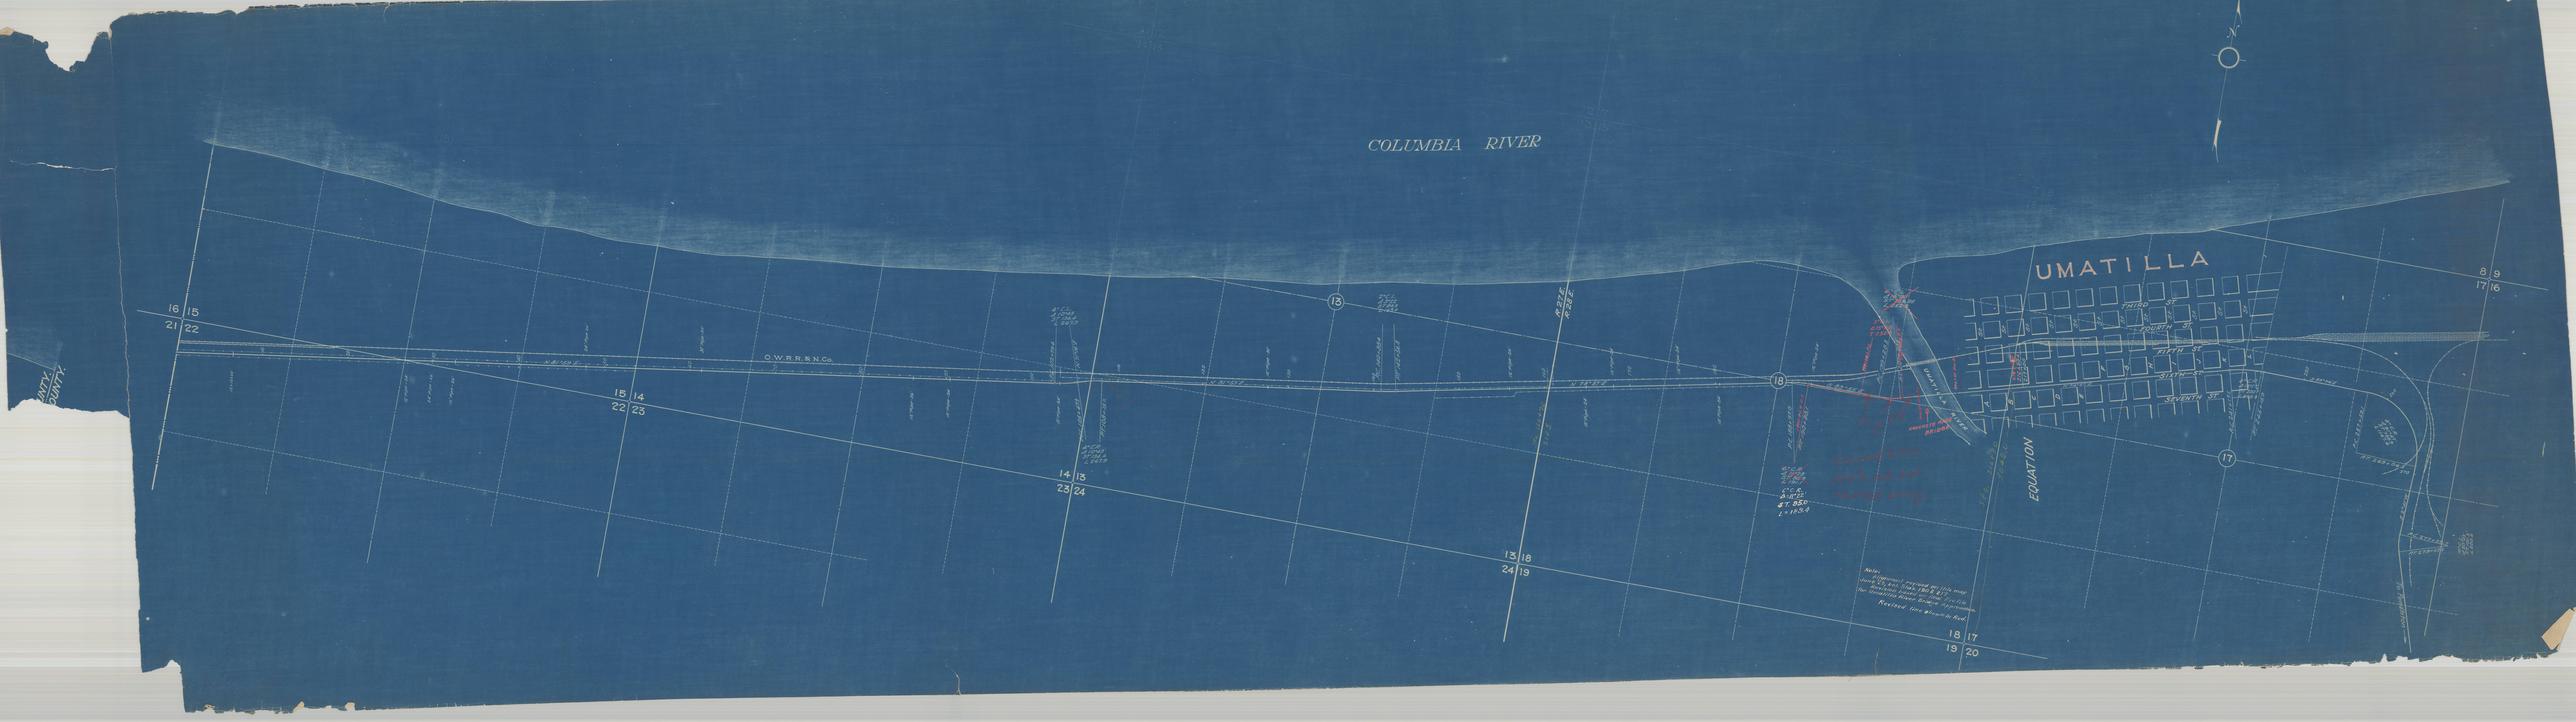
COLUMBIA RIVER
UMATILLA
O.W.R.R.&N.Co.
FIFTH ST.
SIXTH ST.
SEVENTH ST.
EQUATION
16 15
21 22
15 14
22 23
14 13
23 24
13 18
24 19
18 17
19 20
8 9
17 16
13
18
17