UMATILLA COUNTY OREGON

COUNTY ENGINEERS OFFICE

MISSION SOUTH MARKET ROAD

NO. 15

SCALE 1 IN. 400 FT.

SEPTEMBER 1926

CONSTRUCTED LINE
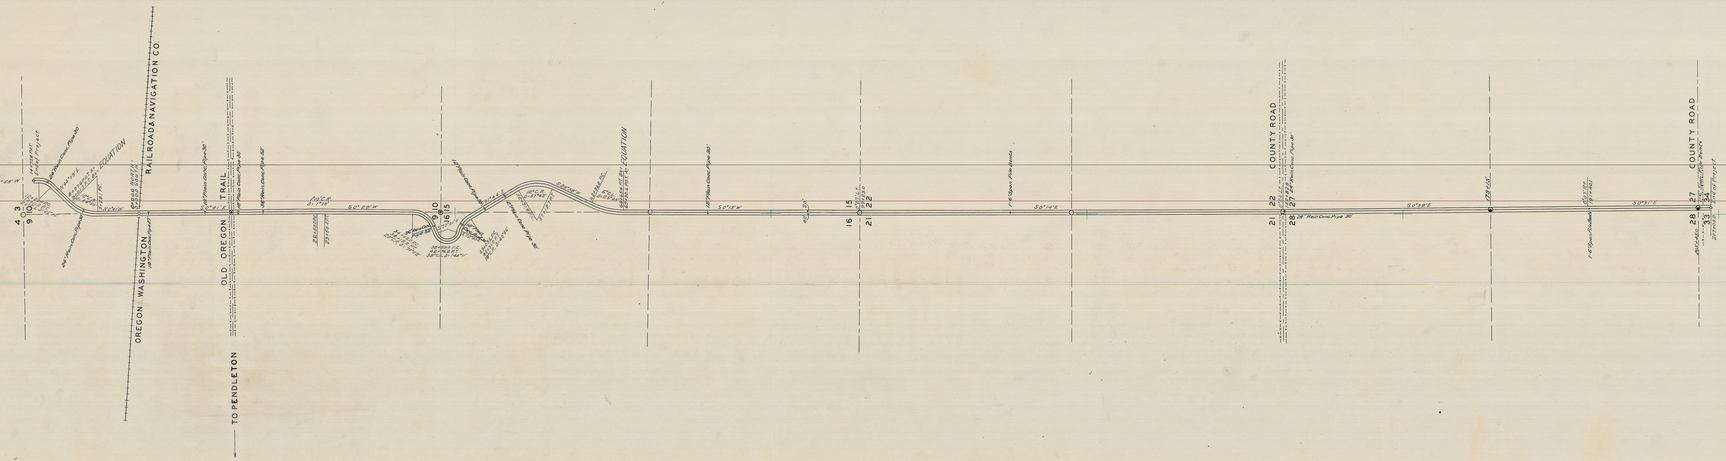
County Rd. No. 823